

FIG. 5

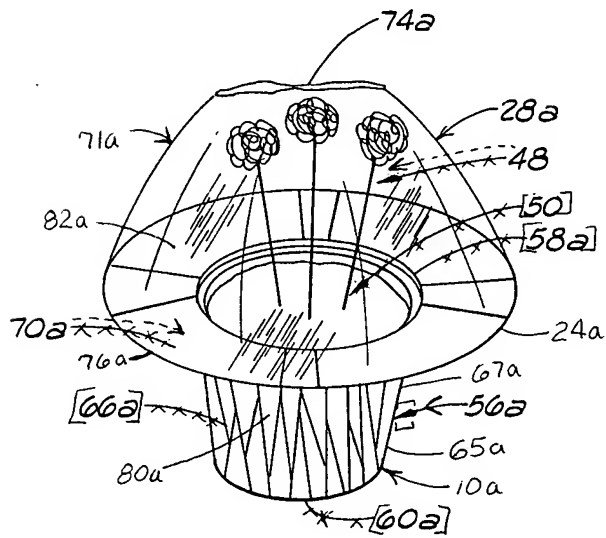


FIG. 6

Redline Version of
 Drawings: Not for
 Publication

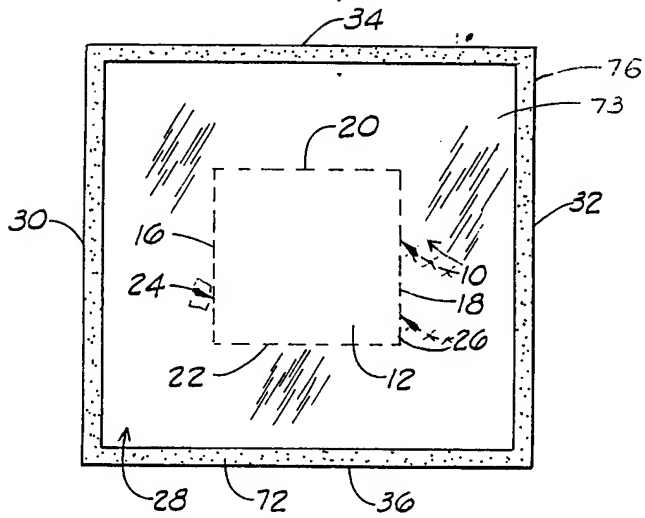


FIG. 1

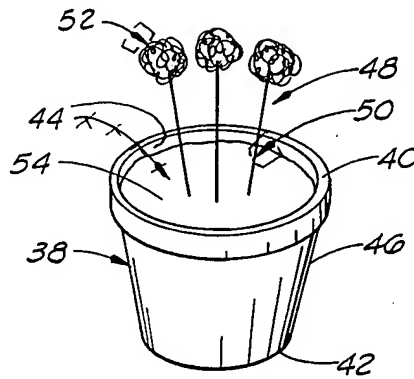


FIG. 2

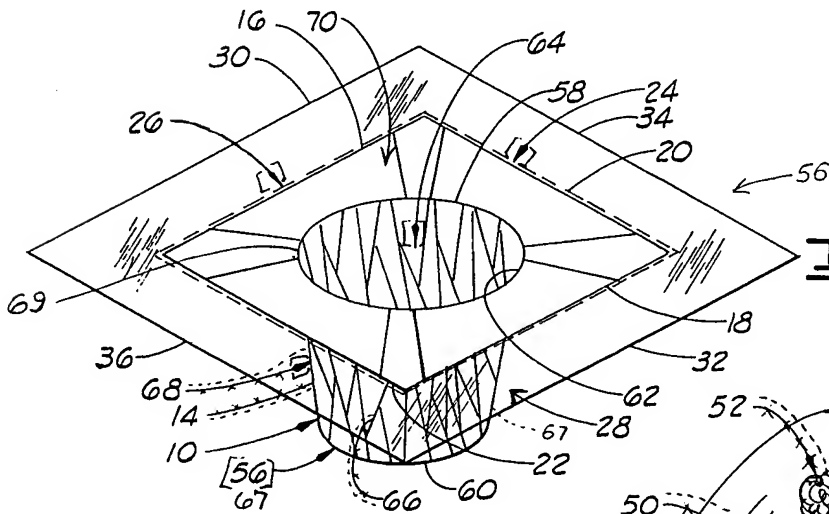


FIG. 3

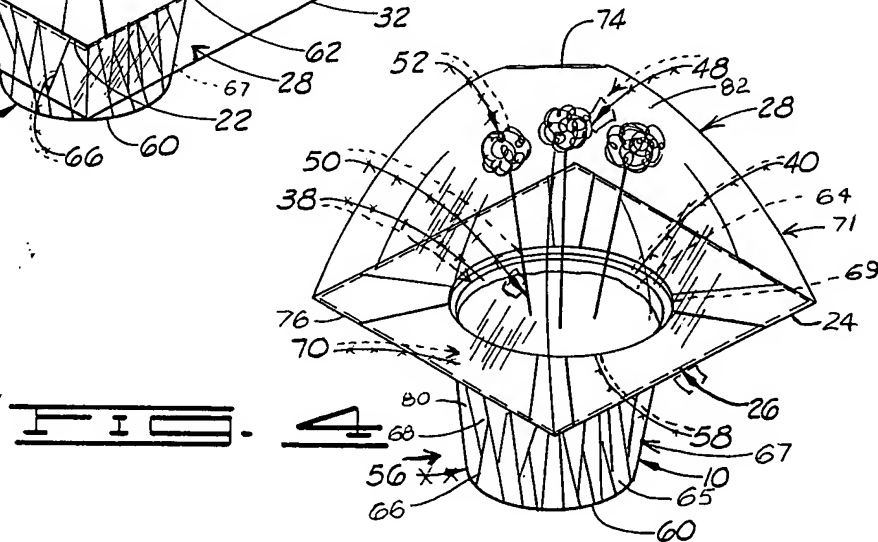


FIG. 4